


THRD TIER

PROTRUDING WALKWAYS TO BE INSTALLED UPON VESSEL'S ARRIVAL AT MOORING BERTH.


PROTRUDING WALKWAYS TO BE INSTALLED UPON VESSEL'S ARRIVAL AT MOORING BERTH.

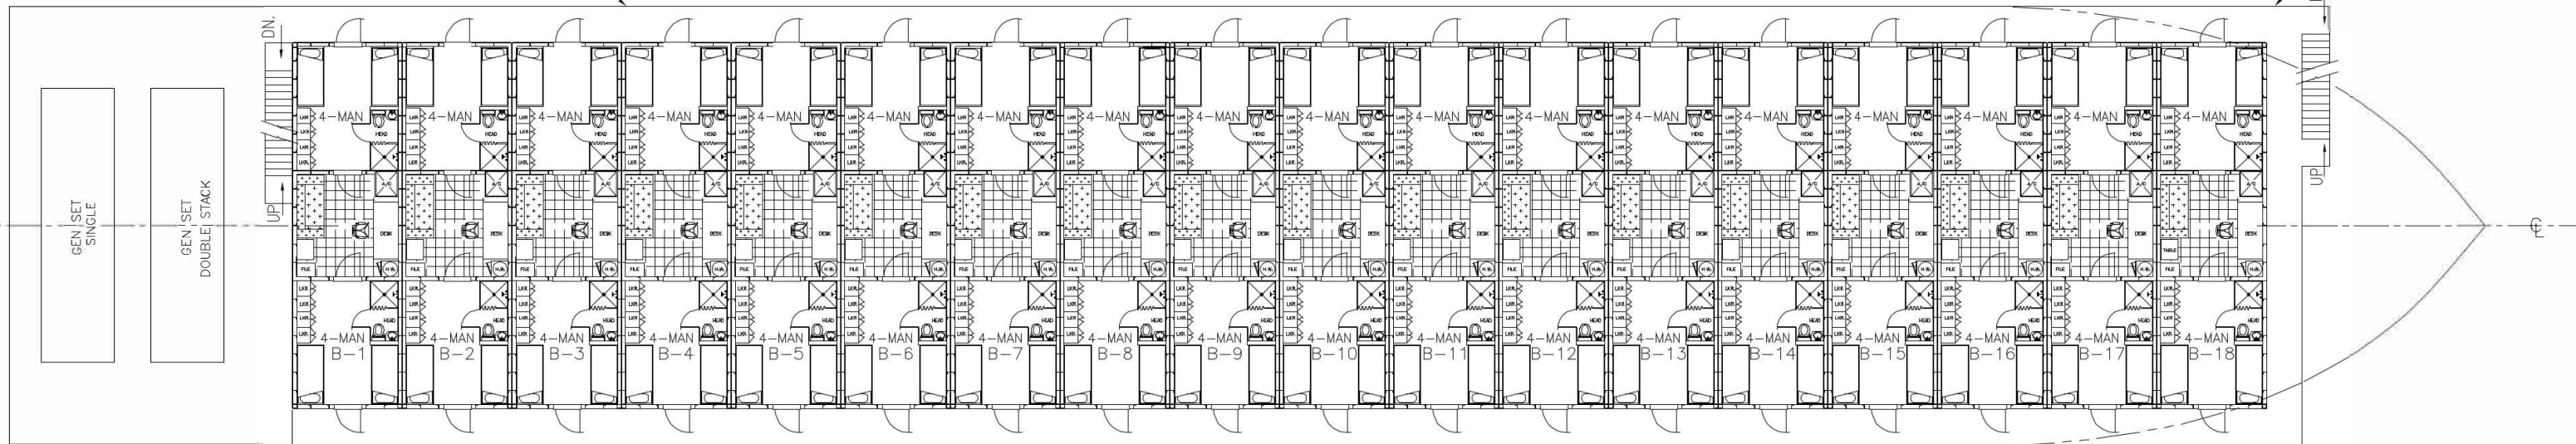

SECOND TIER

GENERAL NOTES

- THIS DRAWING IS CONCEPTUAL AND DEPICTS MODIFICATIONS TO THE QUARTERBOAT No. 24, No. 44.
- HANDRAILS, WALKWAYS & STAIRS TO BE PROVIDED BY BUILDER.

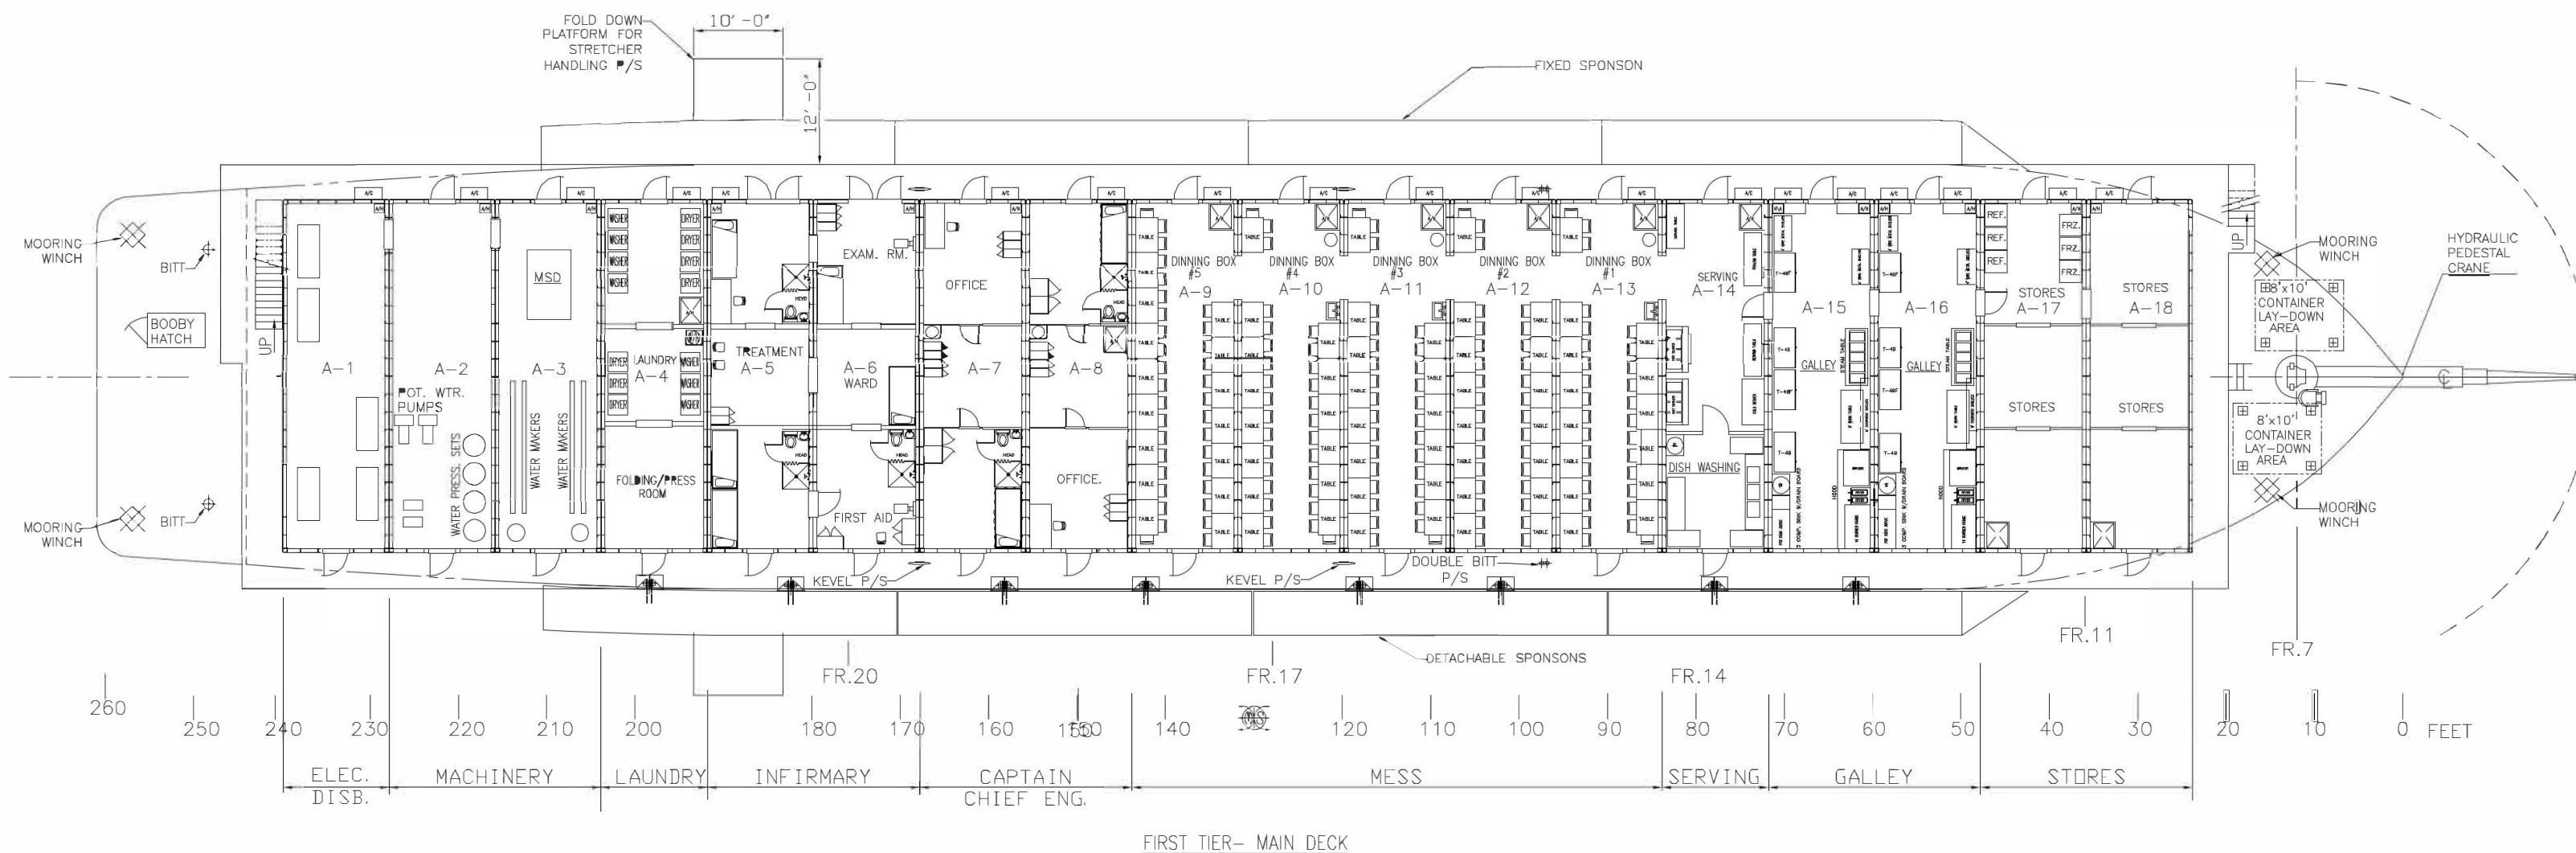

FIRST TIER- MAIN DECK


REV.	DESCRIPTION	DATE	BY
3-01-09	INCORPORATED AS BUILTS		J.G.R.
3-26-09	MODULES MOVED FWD 3'-0" & DETACHABLE SPONSONS SHOWN		J.G.R.
3-06-09	MODIFIED LAUNDRY MODULE A-4, RELOCATED FWD CRANE & ADDED FWD CONTAINER LAY-DOWN AREA		J.G.R.
2-23-09	MODIFIED MESS AND SERVING AREA		J.G.R.
1-26-09	MODIFIED ARRANGEMENT AND ADDED SPONSONS		J.G.R.
1-17-09	MODIFIED ARRANGEMENT		J.G.R.
11-03-08	MODIFIED ARRANGEMENT AND ADDED MODULE NUMBERS		J.G.R.
10-16-08	MODIFIED ARRANGEMENT AS PER CUSTOMER REQUEST.		J.G.R.
9-25-08	CHANGED MODULAR WIDTH TO 46'-0"		J.G.R.
9-24-08	ADDED PEDESTAL CRANE.		J.G.R.
9-18-08	CHANGED MODULAR WIDTH TO 39'-0"		J.G.R.

261'x48'x15' QUARTERS BARGE

GENERAL ARRANGEMENT

COPYRIGHT © 2009 LEARY ENGINEERING


DRAWN BY: J. G. R.	DATE: 8-22-08	JOB NO. 1289	DWG. NO. 1289-01
APPROVED BY:	SCALE: 3/32" = 1'-0"	SHEET: 1 OF 1	REVISION: 11

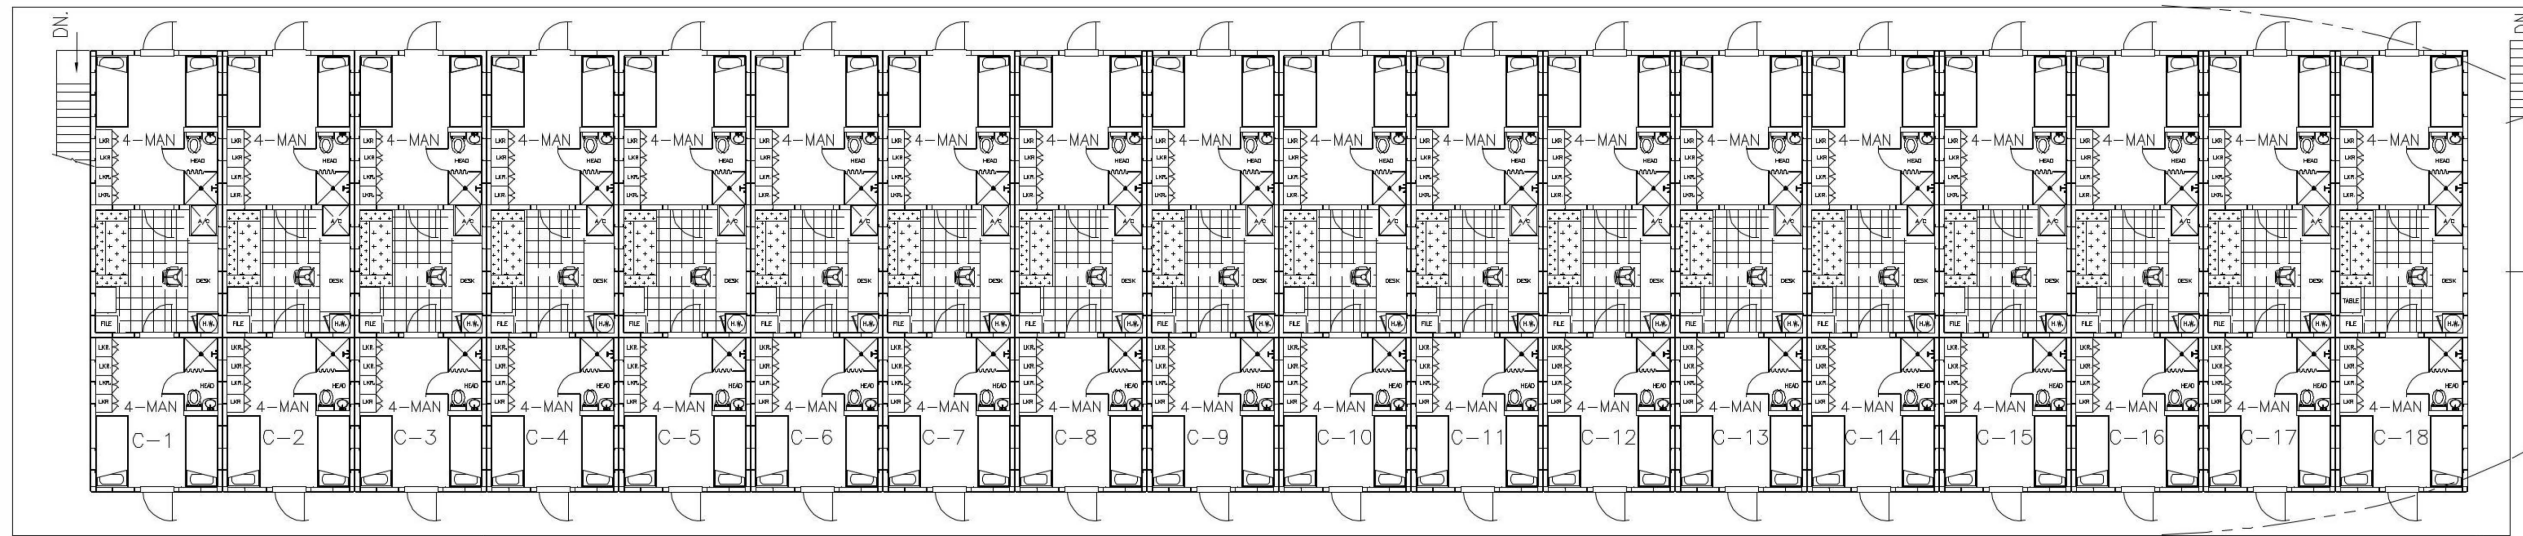

THRD TIER

PROTRUDING WALKWAYS TO BE INSTALLED UPON VESSEL'S ARRIVAL AT MOORING BERTH.


PROTRUDING WALKWAYS TO BE INSTALLED UPON VESSEL'S ARRIVAL AT MOORING BERTH.

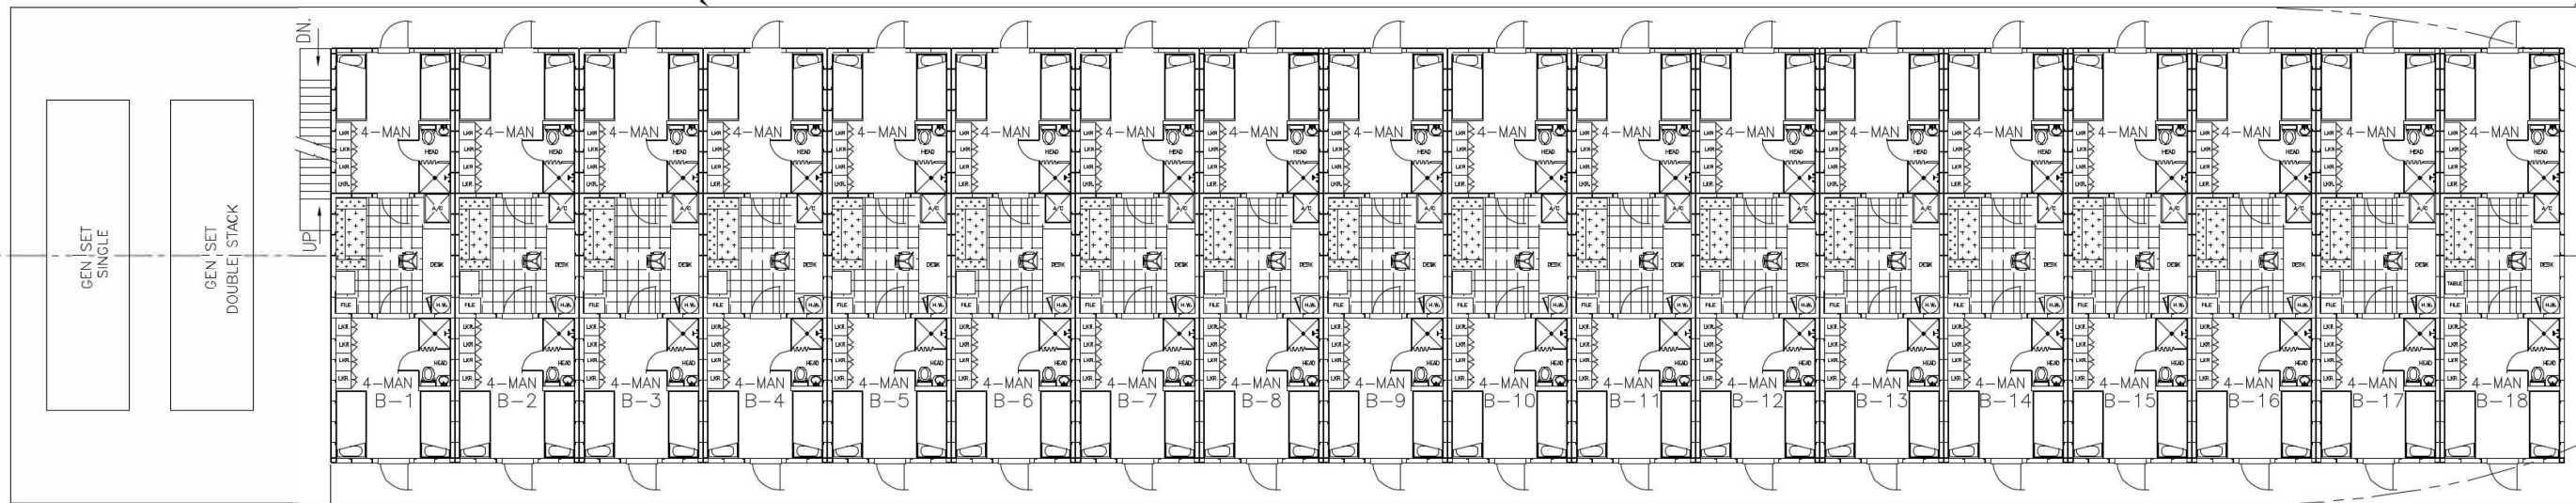

SECOND TIER

GENERAL NOTES

- THIS DRAWING IS CONCEPTUAL AND DEPICTS MODIFICATIONS TO THE QUARTERBOAT No. 24, No. 44.
- HANDRAILS, WALKWAYS & STAIRS TO BE PROVIDED BY BUILDER.

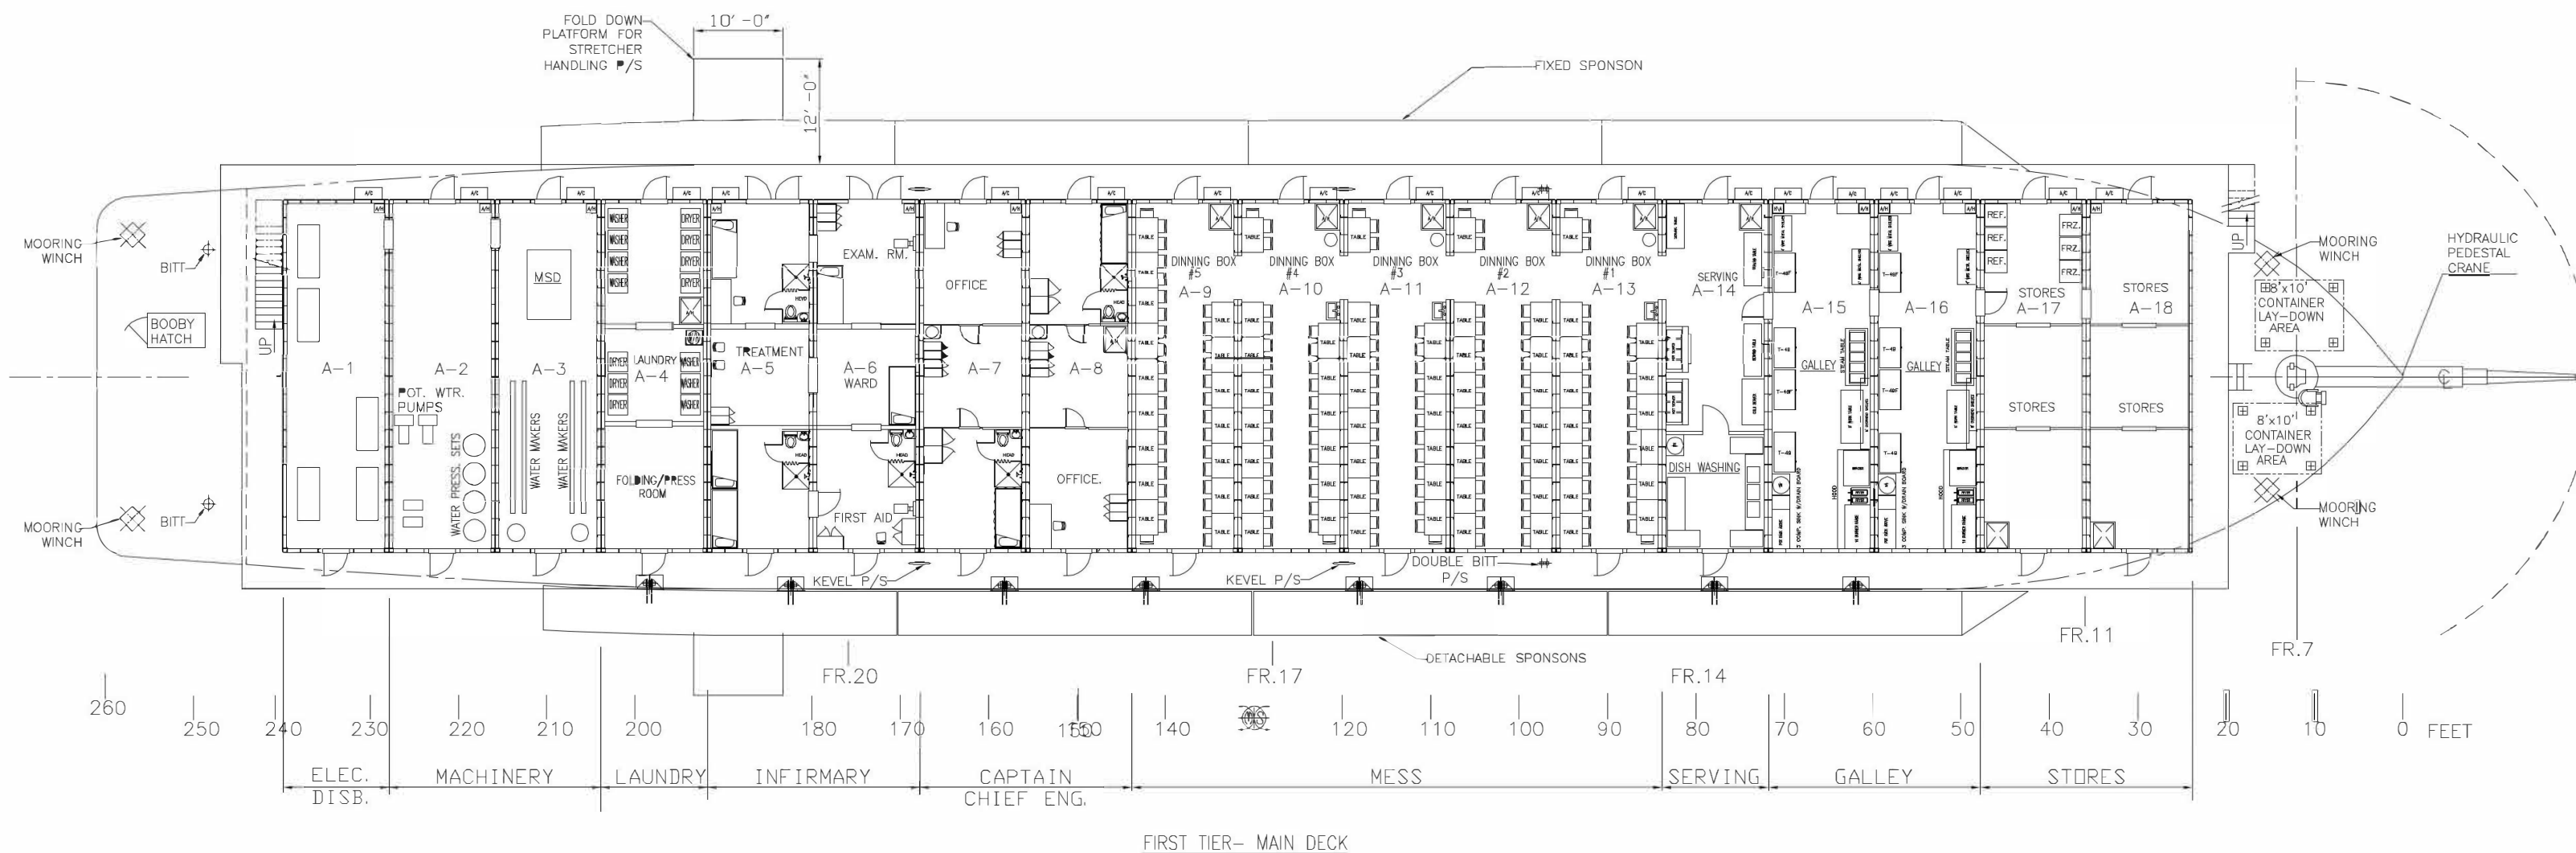

FIRST TIER- MAIN DECK

REV.	DESCRIPTION	DATE	BY
3-01-09	INCORPORATED AS BUILTS		J.G.R.
3-26-09	MODULES MOVED FWD 3'-0" & DETACHABLE SPONSONS SHOWN		J.G.R.
3-06-09	MODIFIED LAUNDRY MODULE A-4, RELOCATED FWD CRANE & ADDED FWD CONTAINER LAY-DOWN AREA		J.G.R.
2-23-09	MODIFIED MESS AND SERVING AREA		J.G.R.
1-26-09	MODIFIED ARRANGEMENT AND ADDED SPONSONS		J.G.R.
1-17-09	MODIFIED ARRANGEMENT		J.G.R.
11-03-08	MODIFIED ARRANGEMENT AND ADDED MODULE NUMBERS		J.G.R.
10-16-08	MODIFIED ARRANGEMENT AS PER CUSTOMER REQUEST.		J.G.R.
9-25-08	CHANGED MODULAR WIDTH TO 46'-0"		J.G.R.
9-24-08	ADDED PEDESTAL CRANE.		J.G.R.
9-18-08	CHANGED MODULAR WIDTH TO 39'-0"		J.G.R.

261'x48'x15' QUARTERS BARGE

GENERAL ARRANGEMENT

COPYRIGHT © 2009 LEARY ENGINEERING

DRAWN BY: J. G. R.	DATE: 8-22-08	JOB NO. 1289	DWG. NO. 1289-01
APPROVED BY:	SCALE: 3/32" = 1'-0"	SHEET: 1 OF 1	REVISION: 11